

EXAMPLE TITLE SHEET

DESIGN DESIGNATION

A.A.D.T. - 2014 = 87,528
 A.A.D.T. - 2034 = 106,801
 D.H.V. = 14%
 T = 11%
 V = 60 M.P.H.
 D = 54% SB, 46% NB
 FUNCTIONAL CLASSIFICATION - INTERSTATE

MISSOURI HIGHWAYS AND TRANSPORTATION COMMISSION

PLANS FOR ~~PROPOSED~~

STATE HIGHWAY

ST. LOUIS CITY

ST. LOUIS COUNTY

DISCLAIMER
 THE PROFESSIONAL WHOSE SIGNATURE AND PERSONAL SEAL APPEAR HEREON ASSUMES RESPONSIBILITY ONLY FOR WHAT APPEARS ON THIS PAGE, AND DISCLAIMS (PURSUANT TO SECTION 327.411 RSMO) SPECIFICATION, ESTIMATES, REPORTS, OR OTHER DOCUMENTS OR INSTRUMENTS NOT SEALED BY THE UNDERSIGNED PROFESSIONAL RELATING TO OR INTENDED TO BE USED FOR ANY PART OR PARTS OF THE PROJECT TO WHICH THIS PAGE REFERS.

INDEX OF SHEETS


DESCRIPTION	SHEET NUMBER
TITLE SHEET	1
TYPICAL SECTIONS (TS) (2 SHEETS)	2
QUANTITIES (QU) (17 SHEETS)	3
PLAN-PROFILE (PP)	4-19
ADA SHEETS (ADA)	20-29
PAVEMENT MARKING (PM)	30-50
SIGNALS (SG)	59-77
LIGHTING (LT)	78-80
TRAFFIC CONTROL (TC)	81-102
SIGNING (SN)	103-104
BRIDGE DRAWINGS (B)	
A0531	1-2

THIS MEDIA SHOULD NOT BE CONSIDERED A CERTIFIED DOCUMENT.

DATE PREPARED
11/13/2015
 ROUTE I-55 STATE MO
 DISTRICT SL SHEET NO. 1
 COUNTY ST. LOUIS CITY
 ST. LOUIS COUNTY
 JOB NO. J613017
 CONTRACT ID. 160122-F04
 PROJECT NO.

BRIDGE NO.

DATE	DESCRIPTION

MISSOURI HIGHWAYS AND TRANSPORTATION COMMISSION

 105 WEST CAPITOL
 JEFFERSON CITY, MO 65102
 1-888-ASK-MODOT (1-888-275-6636)


AS-BUILT PLANS

NO NEW RIGHT OF WAY IS REQUIRED FOR THIS PROJECT.

CONVENTIONAL SYMBOLS (USED IN PLANS)

EXISTING	NEW
BUILDINGS AND STRUCTURES	
GUARD RAIL	
CONCRETE RIGHT-OF-WAY MARKER	
STEEL RIGHT-OF-WAY MARKER	
LOCATION SURVEY MARKER	
UTILITIES	
FIBER OPTICS	
OVERHEAD TELEPHONE	
UNDERGROUND TELEPHONE	
OVERHEAD POWER	
UNDERGROUND POWER	
GAS	
WATER	
MANHOLE	
FIRE HYDRANT	
WATER VALVE	
WATER METER	
DROP INLET	
DITCH BLOCK	
GROUND MOUNTED SIGN	
LIGHT POLE	
H-FRAME POWER POLE	
TELEPHONE PEDESTAL	
FENCE	
CHAIN LINK	
WOVEN WIRE	
GATE POST	
BENCHMARK	

NOTE: DASHED OR OPEN SYMBOLS INDICATE EXISTING FEATURES.

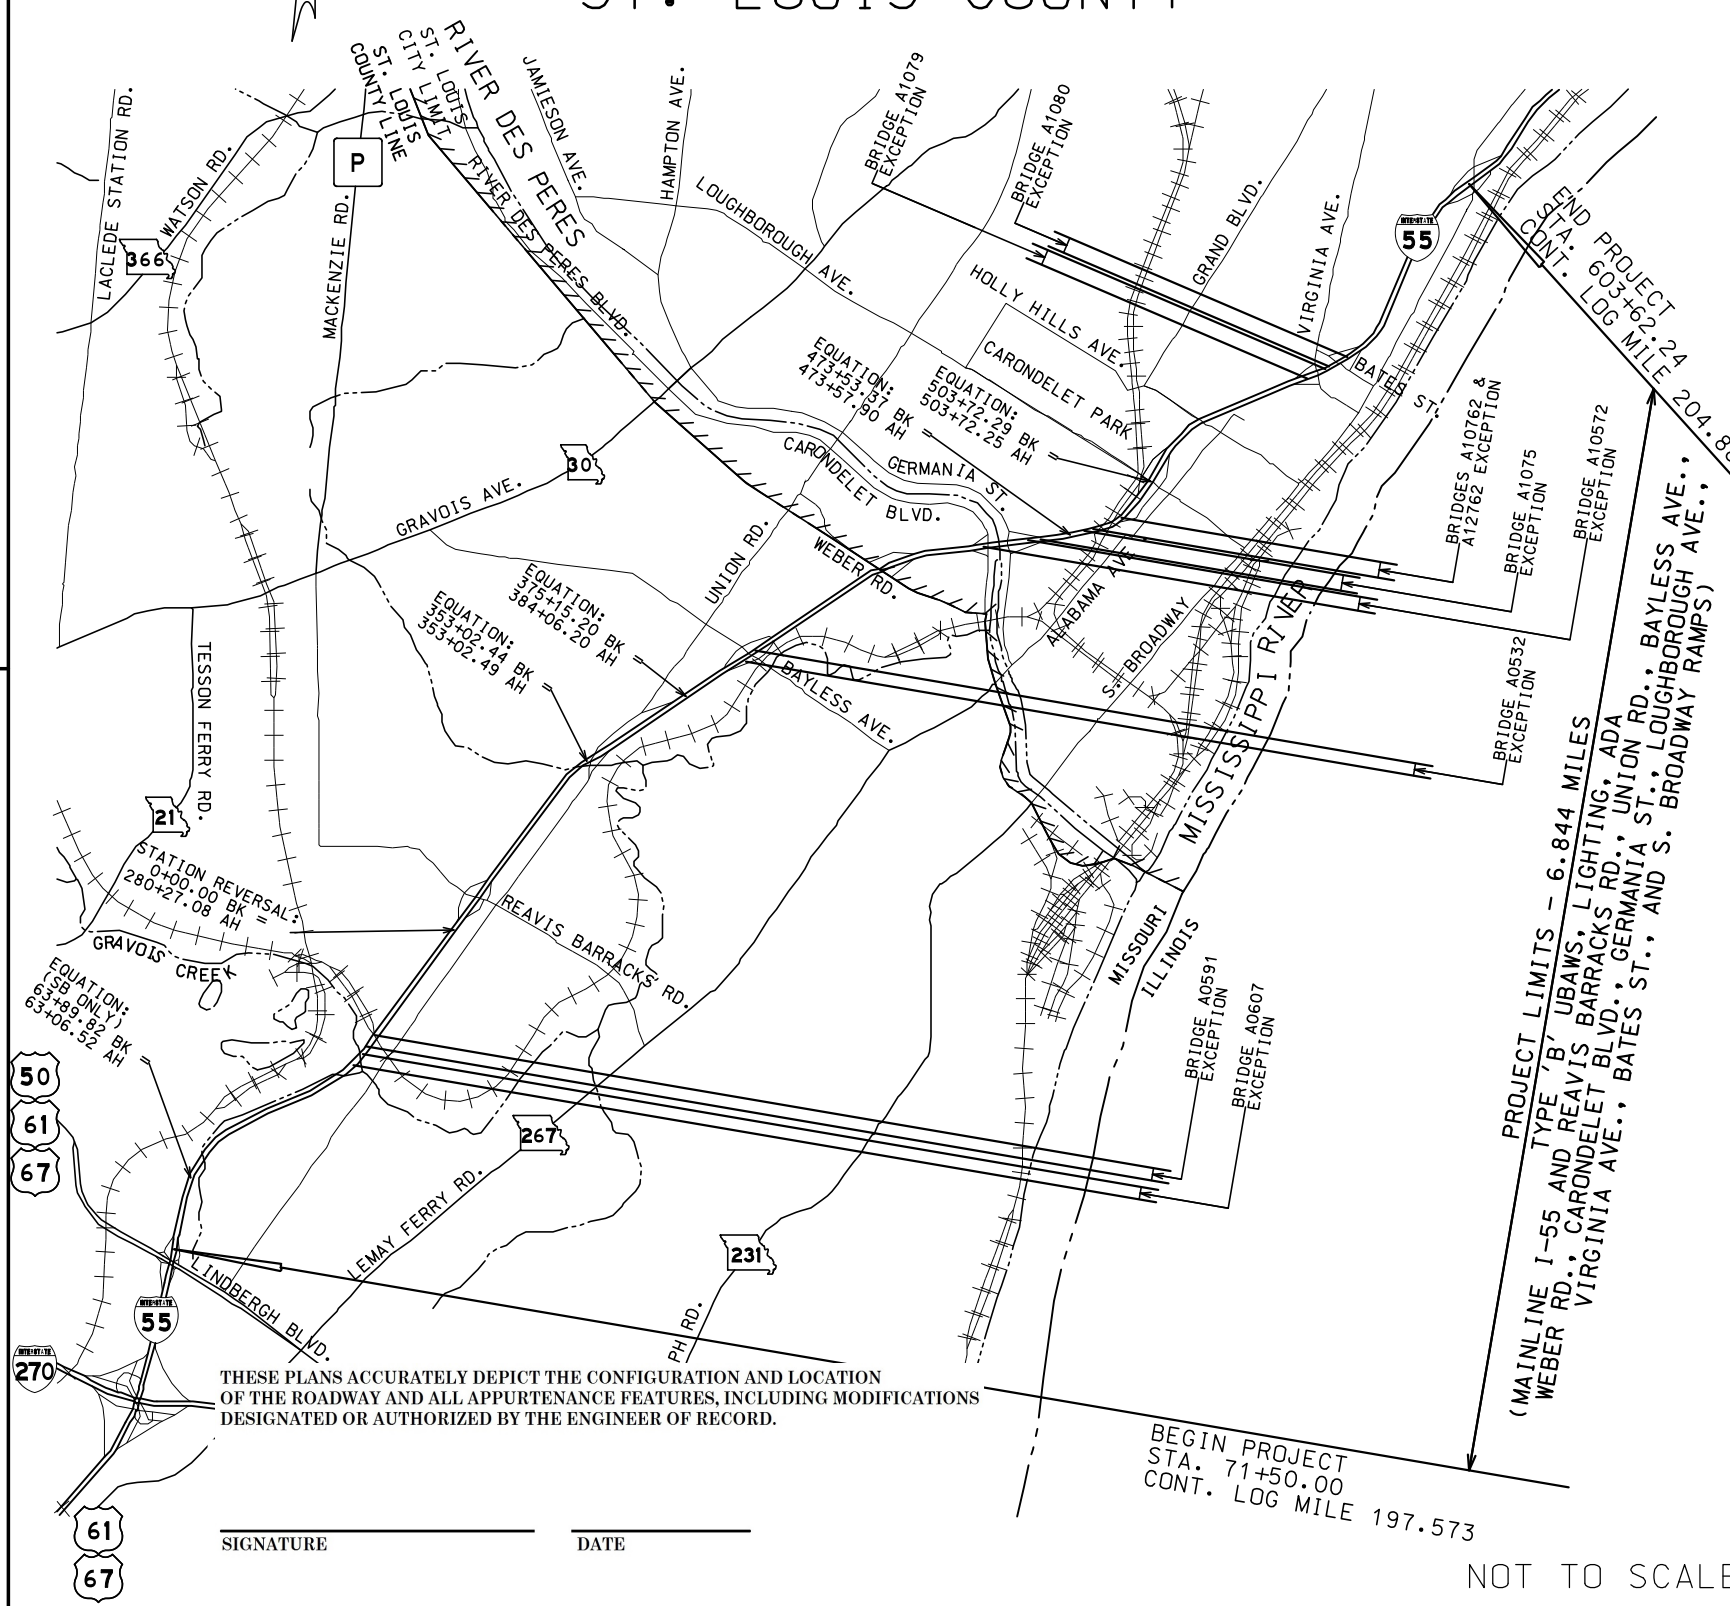

LENGTH OF PROJECT

BEGINNING OF PROJECT STA.	71 + 50.00
END OF PROJECT STA.	603 + 62.24
APPARENT LENGTH (INCLUDES STATION REVERSAL)	67,512.24 FEET
EQUATIONS AND EXCEPTIONS:	
EQUATIONS:	
0+00.00 BK = 280+27.08 AH	-28,027.08 FEET
353+02.44 BK = 353+02.49 AH	-0.05 FEET
375+15.20 BK = 384+06.20 AH	-891.00 FEET
473+53.37 BK = 473+57.90 AH	-4.53 FEET
503+72.29 BK = 503+72.25 AH	0.04 FEET
SB ONLY: 63+89.82 BK = 63+06.52 AH	INFO ONLY
BRIDGE EXCEPTIONS:	
1-55 OVER GRAVOIS CREEK (A0607)	
7+17.00 TO 9+83.87	-266.87 FEET
1-55 OVER GREEN PARK ROAD/GRANT'S TRAIL (A0591)	
2+28.72 TO 4+71.28	-242.56 FEET
1-55 OVER BAYLESS AVENUE (A0532)	
403+80.08 TO 405+77.35	-197.27 FEET
NB OVER CARONDELET BOULEVARD/RIVER DES PERES/GERMANIA STREET (A10572)	
462+57.62 TO 468+55.89	-598.27 FEET
SB OVER CARONDELET BOULEVARD/RIVER DES PERES/GERMANIA STREET (A10572)	
462+71.12 TO 468+55.88	INFO ONLY
1-55 OVER KOELN AVENUE (A1075)	
478+76.93 TO 480+47.83	-170.90 FEET
NB OVER UNION PACIFIC RR (A10762)	
483+63.39 TO 490+19.80	-656.41 FEET
SB OVER UNION PACIFIC RR (A12762)	
484+46.98 TO 491+03.86	INFO ONLY
1-55 OVER VIRGINIA AVENUE (A1079)	
546+91.21 TO 548+47.21	-156.00 FEET
1-55 OVER BATES ST (A1080)	
552+26.13 TO 553+90.56	-164.43 FEET
TOTAL CORRECTIONS	-31,375.33 FEET
NET LENGTH OF PROJECT	36,136.91 FEET
STATE LENGTH	6.844 MILES

NOT TO SCALE

IF A SEAL IS PRESENT ON THIS SHEET IT HAS BEEN ELECTRONICALLY SEALED AND DATED.